
MAP OF SURVEY

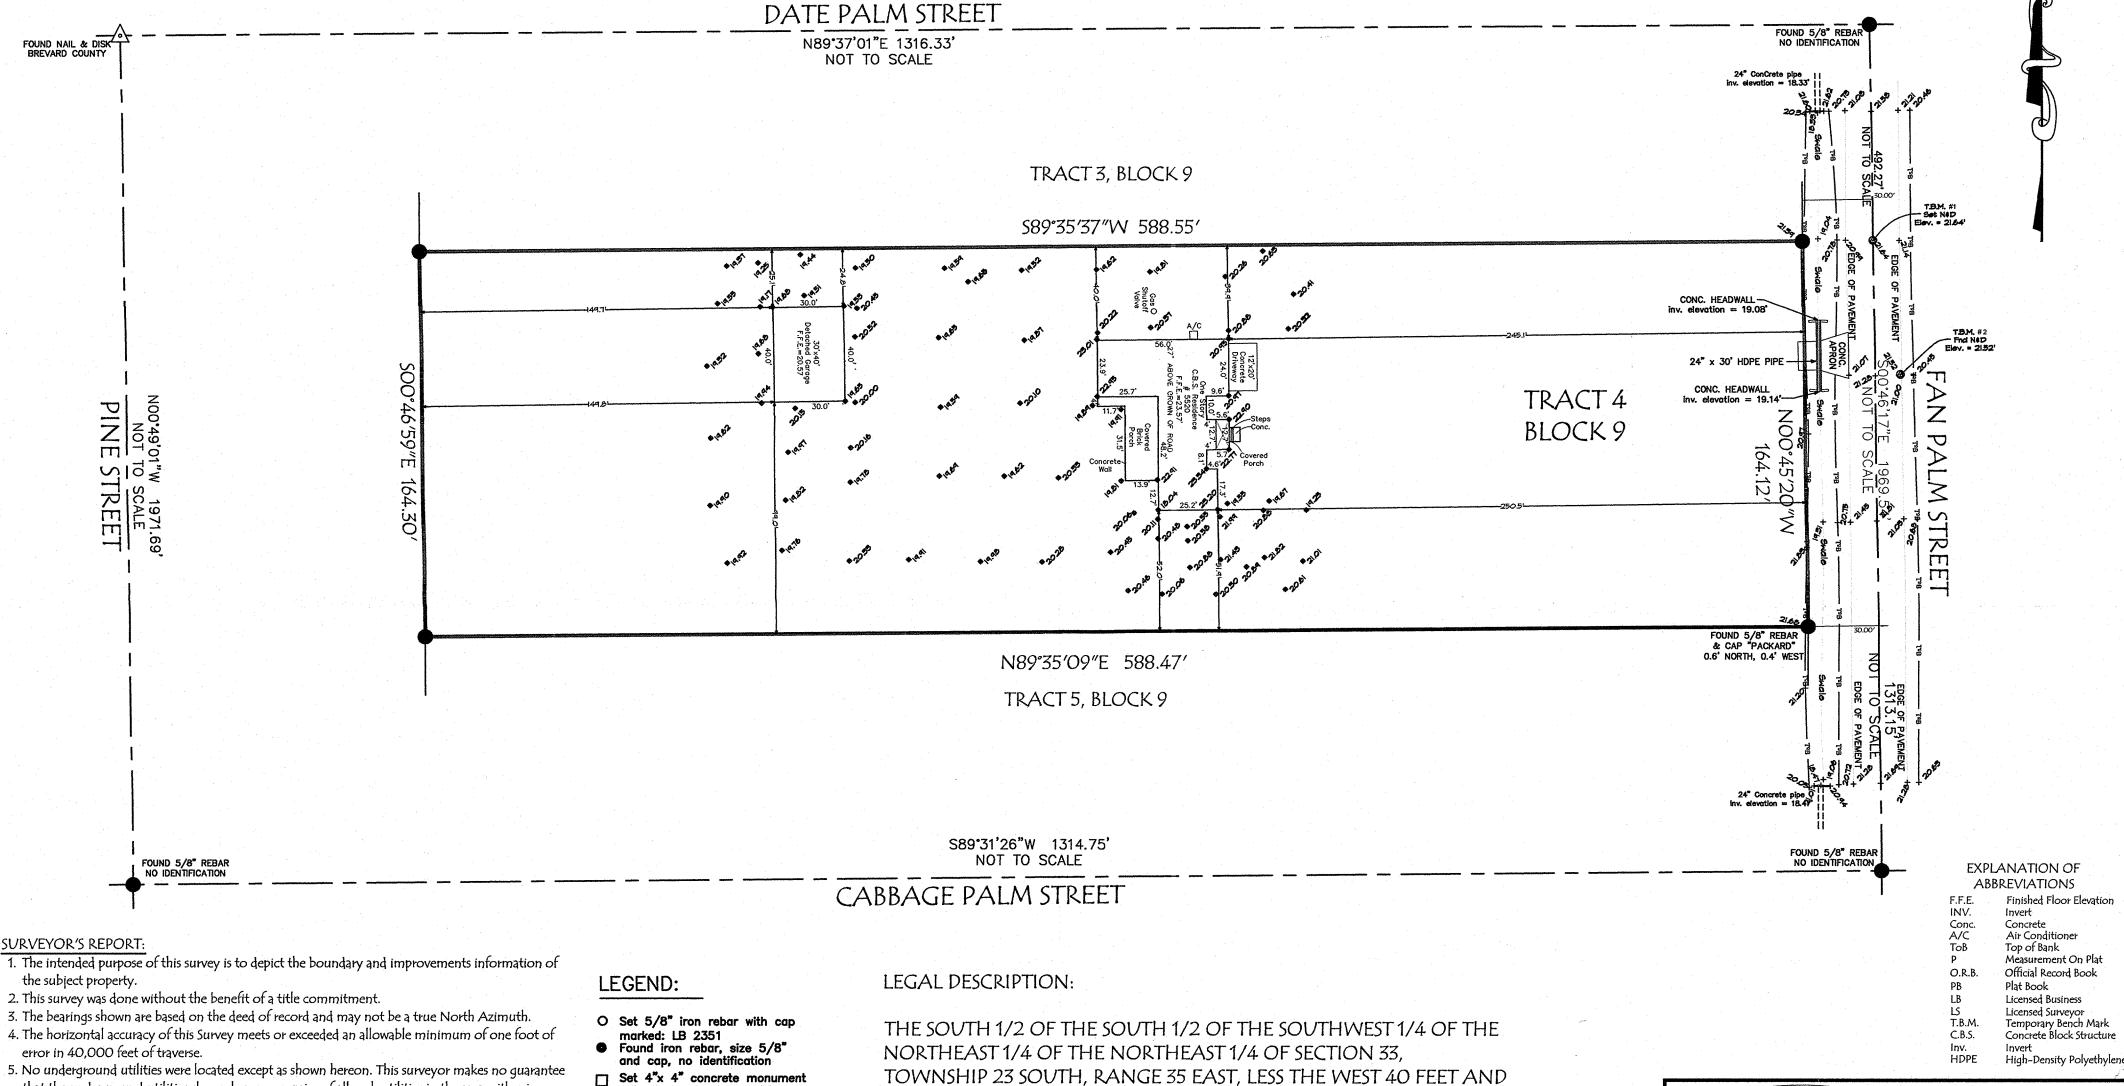

SURVEYOR'S REPORT:

- 4. The horizontal accuracy of this Survey meets or exceeded an allowable minimum of one foot of
- that the underground utilities shown heron comprise of all such utilities in the area, either in
- 6. All dimensions shown on this drawing are based of US feet measurement and or decimal parts there
- 7. All measurement are in agreement with record or deed calls unless otherwise stated or shown.
- 8. This Survey is not valid without the signature and raised seal of a Florida Licensed Surveyor.
- 9. The Elevations as shown hereon are references to NAVD '88' Vertical Datum from a Brevard County Benchmark designated "195 73 A78" having a Published Elevation of "46.390" NAVD '88'.

FEMA FLOOD FOR INFORMATION ONLY: The surveyor no longer certifies the F.E.M.A. Flood Zones. This certification is made by an independent contractor of the Federal Government. As a courtesy to the client, this surveyor feels that the subject parcel appears to lies in F.I.R.M. Zone "X" per Community Panel No.

- with disk marked: LB 2351
- Found concrete monument, size and identification #
- Δ Set nail and disk marked:
- LB 2351

▲ Found nail and disk, As Noted

TOWNSHIP 23 SOUTH, RANGE 35 EAST, LESS THE WEST 40 FEET AND THE EAST 30 FEET THEREOF, LYING AND BEING IN BREVARD COUNTY, FLORIDA a/k/a TRACT 4, BLOCK 9, CANAVERAL GROVES UNRECORDED, RECORDED IN SURVEY BOOK 2, PAGE 55, PUBLIC RECORDS OF BREVARD COUNY, FLORIDA.



I hereby certify that the survey shown hereon is true and correct based on actual measurements taken in the field. This survey meets the Standard of Practice as set forth by the Florida Board of Professional Land Surveyors found in Chapter 5J-17.052,

UNLESS IT BEARS THE SIGNATURE AND ORIGINAL RAISED SEAL OF A FLORIDA LICENSED SURVEYOR AND MAPPER THIS DRAWING, SKETCH, PLAT OR MAP IS FOR INFORMATIONAL PURPOSES ONLY AND IS

Florida Administrative Code, pursuant to Section 472.027, Florida Statutes. John R. Campbell Professional Surveyor & Mapper #2351 State of Florida

Revisions

th	6	Final/As-Built 02-04-21 Z.A. Dyer
	5	Final Survey with Topography 10-28-20 Z.A. Dyer
	4	Foundation/Stem wall Survey 8-10-20 Z.A. Dyer
	3	Foundation / Stem wall Survey 3-19-19 E.L.Hale
	2	Add RW Topo 2-27-19 E.L.Hale
	1	Add Trees 10-14-18 E.L.Hale

115 Alma Blvd., Suite 102 Mailing Address: P.O.Box 541866 Merritt Island, FL. 32954 Phone: (321) 514.6920 LICENSED BUSINESS #7978

Boundary Survey

1"=40' Certified to: LINDA M & ERRAN L. MUENZ Jr. MIDWEST LOAN SOLUTIONS INTERNATIONAL TITLE AND ESCROW CO., LLC WFG TITLE AND ESCROW COMPANY, LLC

06/30/17 Project#

2017-245

C.D.

Scale: