CODE CRITERIA


- FLORIDA BUILDING CODE SEVENTH EDITION (2020)
- FLORIDA FIRE PREVENTION CODE 7th EDITION (2020)
- BUILDING CODE REQUIREMENTS FOR REINFORCED CONCRETE (ACI 318-14)
- SPECIFICATIONS FOR STRUCTURAL CONCRETE BUILDINGS (ACI 301-14)
- BUILDING CODE FOR MASONRY STRUCTURES (TMC 402-2016)
- SPECIFICATIONS FOR STRUCTURAL STEEL BUILDINGS (AISC 360-16)
- NATIONAL DESIGN SPECIFICATION FOR WOOD CONSTRUCTION NDS-2018
- WOOD FRAMED CONSTRUCTION MANUAL 2015 EDITION
- APA PLYWOOD DESIGN SPECIFICATION
- AMERICAN SOCIETY OF CIVIL ENGINEERS: ASCE/SEI 7-16

NOTES:

- 1) 5000 psi Concrete
- 2) 0.040 WCR max
- 3) Min Overlap as per ACI
- 4) Steel to be ASTM A615 Grade 60
- 5) 2" Concrete cover min.
- 6) Dowel epoxy 12" into solid concrete wherever possible.
- Minimum Bearing to be 4" on each end



AREA OF WORK

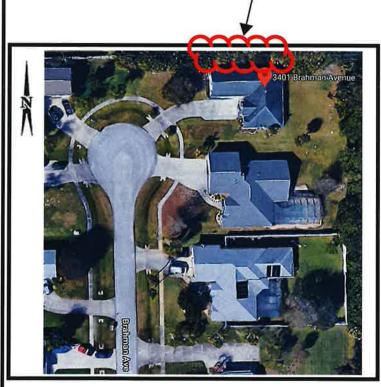

VICINITY MAP SCALE: NTS

PROJECT: Kurt & Tina Krokenberger Residence

3401 Brahman Ave Rockledge, FL 32955

DETAIL: As Built Wall Detail

SCALE: NTS

PAGE 1 OF 2

WIND LOADING CRITERIA


WIND SPEED (ULTIMATE) WIND SPEED (ALLOWABLE) EXPOSURE CATEGORY BUILDING CATEGORY BUILDING TYPE ENCLOSURE CLASSIFICATION INTERNAL PRESSURE COEFFICIENT

150 MPH 116 MPH OPEN +/- 0.0

NOTE: MEAN ROOF HEIGHT FOR TYPICAL SINGLE STORY HOME IS 15FT, AND FOR 2 STORY HOME IS 30FT

ASCE 7-16 WALL DESIGN ALLOWABLE COMPONENTS AND CLADDING WIND PRESSURES AND SUCTIONS FOR MEAN ROOF HEIGHT ≤ 60 ft

EFFECTIVE WIND AREA (SQ FEET)	WIND PRESSURE AND SUCTION (PSF) (+) VALUE DENOTES PRESSURE (-) VALUE DENOTES SUCTION	
AREA	4	(5)
10	(+) 42.3 (-) 45.9	(+) 42.3 (-) 56.6
20	(+) 40.4 (-) 44.0	(+) 40.4 (-) 52.8
50	(+) 37.9 (-) 41.4	(+) 37.9 (-) 47.8
100	(+) 36.0 (-) 39.5	(+) 36.0 (-) 44.0

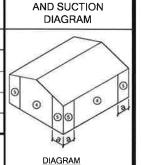

WIND PRESSURE

SCOPE OF WORK:

- 1) Construct a new 3 foot wide by 4" deep concrete walkway along entire north wall of building.
- 2) Construct a new concrete continuous footing running east to west along the northern end of the property.
- 3) Construct a 92 linear foot long 6' high concrete masonry retaining wall.
- 4) Transition to an additional 48 linear foot 2 foot high (3 courses) concrete masonry wall.




This item has been digitally signed and sealed by [Tomas Ponce PE, FL # 0050068], on the date adjacent to the seal. Printed copies of this document are not considered signed and sealed and the signature must be verified on any electronic copies.





Tomas Ponce MSCE, PE FL PE#50068 01/25/2022 Date:

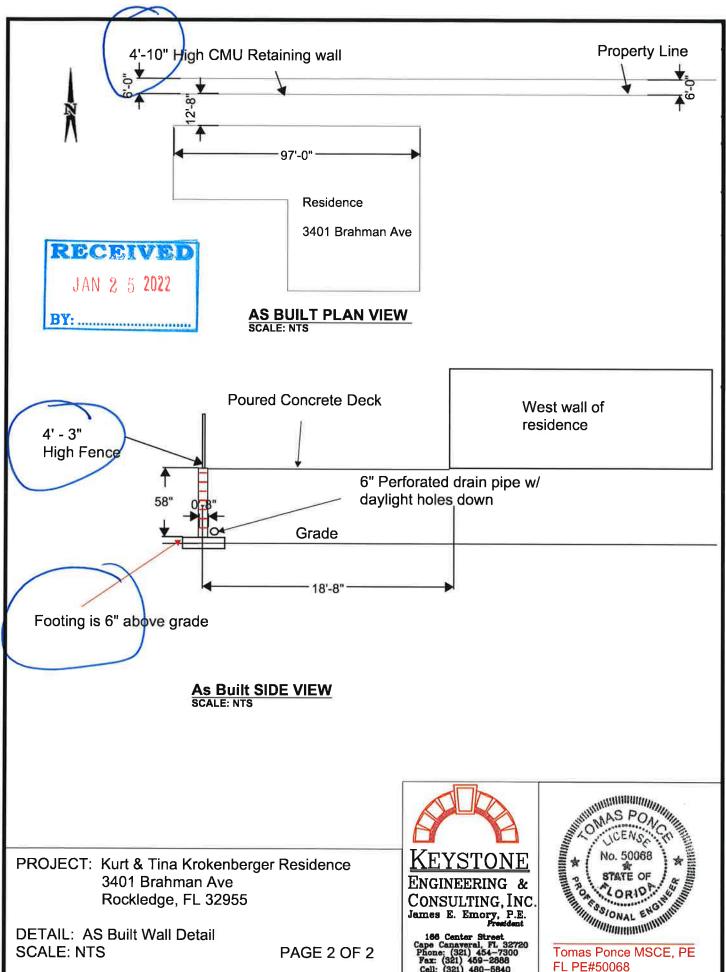

Date:

01/25/2022