
Consolazio

OF SKETCH SURVE

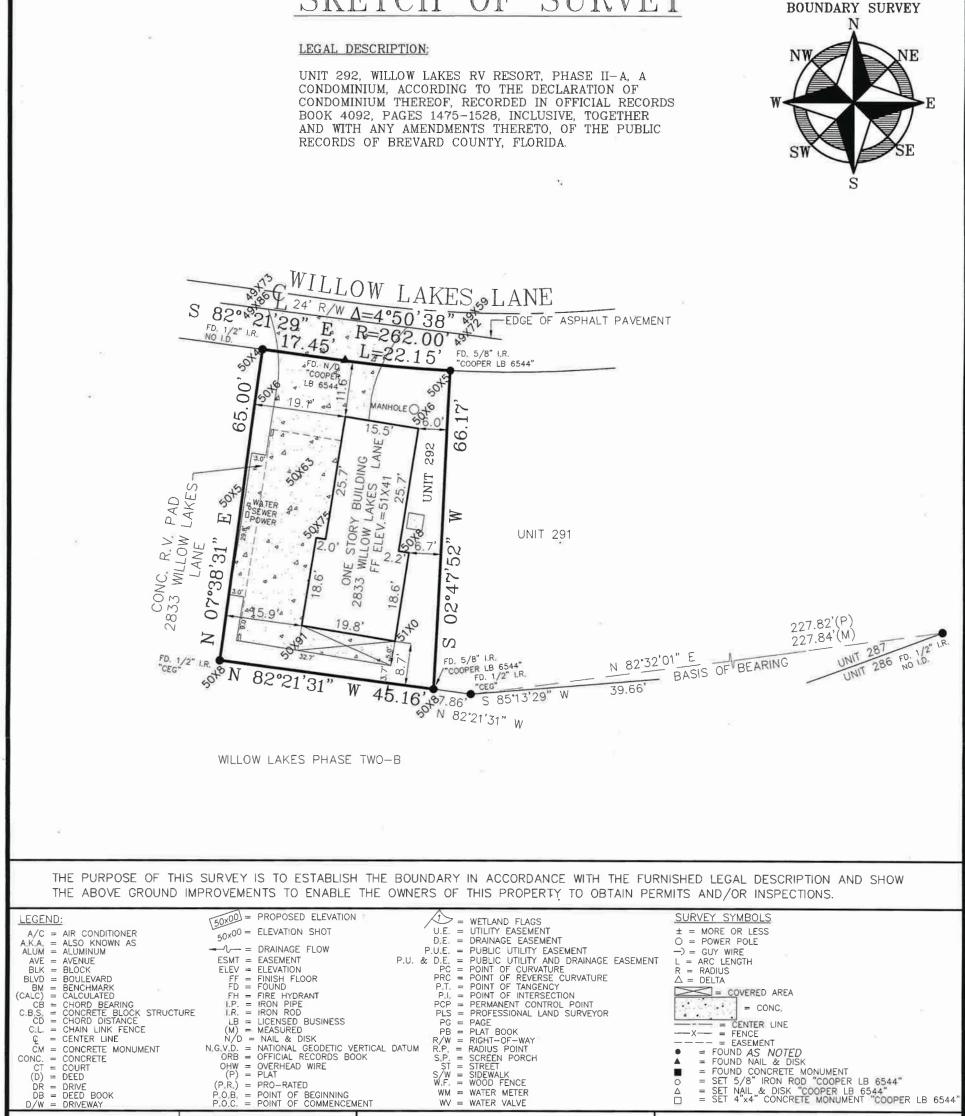

POB POC VEYORS NOTES

DRAWN BY: JAB	CHECKED DI. J.W.C.	JR
SCALE: 1" = 20'	1.	
SECTION 20, TOWNSHI	P 21 S., RANGE 35 E.	
LEGAL DESCRIPTION: SEE ABOVE		
according to the plat	thereof as recorded in 4.	
Plat Book at Page(s) of the Public Records of Brevard County, Florida.		
CERTIFIED TO:		
MICHAEL JOHN CONS SONYA LYNN CONSO		
	** sar 57.	
	ATE REVISION 8.	
21-03-30 4/ 21-06-26 6/1 22-02-04 2/ 22-02-04 4/2 SURVEY DATE: 2/10/22 PR	27/21 COUNTY COMMENTS 4/21 CONCRETE FOUNDATION 10/22 FINAL / AS BUILT 25/22 ADD BUILDING TIE ROJECT # 22-02-04	

Unless otherwise noted, only platted easements are shown hereon.

WV = WATER VALVE

- No underground utilities or improvements were located unless otherwise shown.
- The surveyor no longer certifies the $\mathsf{F}.\mathsf{E}_{\bullet}\mathsf{M}.\mathsf{A}_{\bullet}$ Zone. This certification is made by an independent contractor of the Federal Government. As a courtesy to the client, this surveyor feels that this parcel lies in F.I.R.M. Zone X per Community Panel No. 125092C0115H, dated 1/29/21.
- Unless otherwise noted, any elevations shown are based on assumed datum,
- Bearing shown hereon are based on the DRAWING AS SHOWN ON THE SURVEY as being N 82'32'01" E, according to the LEGAL DESCRIPTION as recorded in ORB 4092, at page 1475 of the Public Records of Brevard County, Florida.
- This survey is prepared and certified for the exclusive use of the client named hereon
- Unless this sketch of survey bears the signature and raised seal of John W. Cooper PLS 5093, it is for information purposes only and is not a valid survey.
- Additions or deletions to this sketch of survey by other than the signing party is prohibited without written consent of the signing party.
- Ownership of fences is unknown unless otherwise noted. Due to the nature of fences it is recommended that you contact the undersigned surveyor prior to removal or installation of any fence.

AND SURVEYING II 2326 s. hopkins avenue Titusville, Florida 32780 LB 6544 (321) 268-5646 FAX (321) 268-5688

I hereby certify that this survey meets the Standards of Practice as set forth by the Florida Department of Agriculture and Consumer Services in Chapter 5J-15.051 Florida Administrative Code, Pursuant to section 472.027, Florida Statutes.

PSM 5093

Cooper

Date Signed